



ATTACHMENT C RETAINING WALL DETAIL

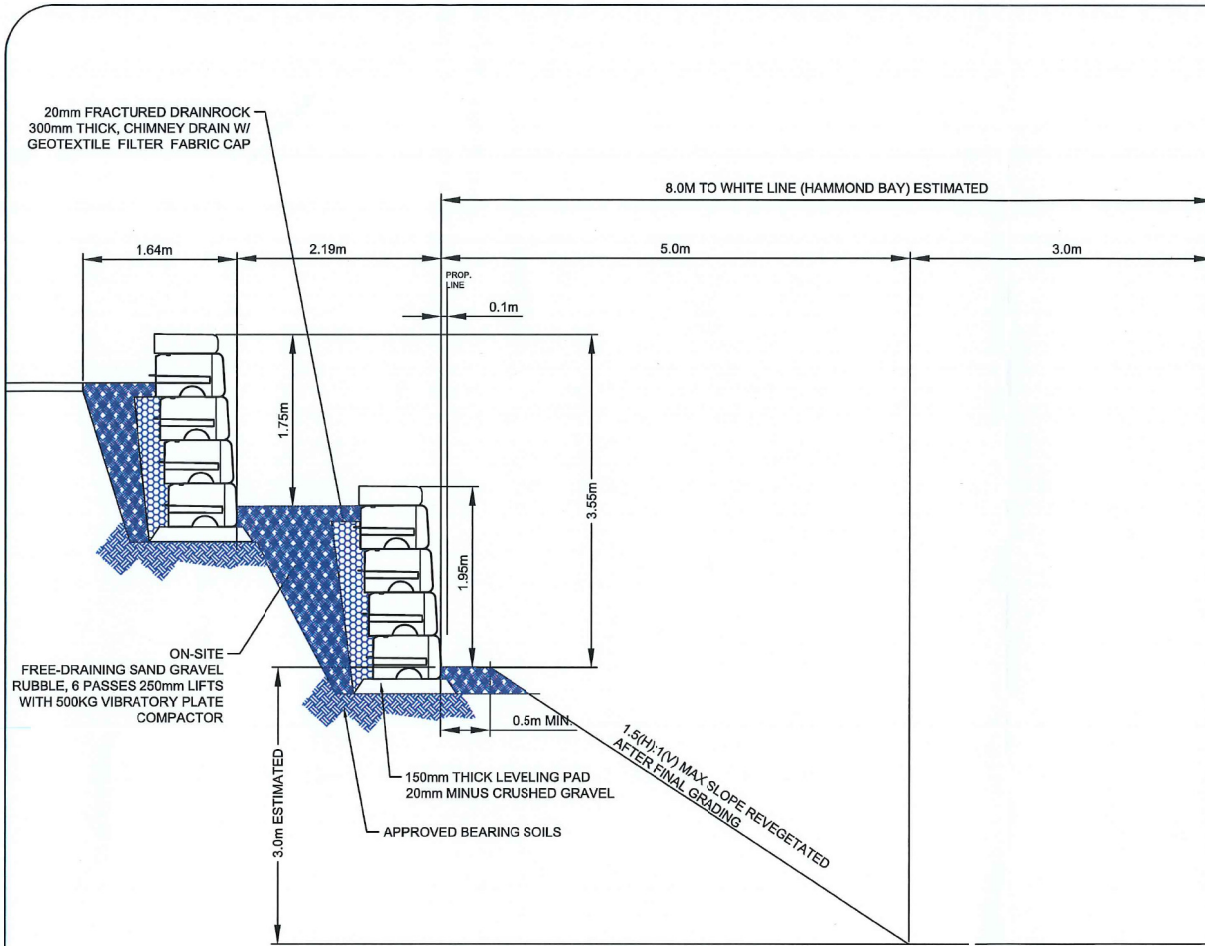

- NOTES:
- REDI-ROCK 28" DEEP INTERLOCKING BLOCKS
 - SCH B-C, GEOTECHNICAL QUALITY ASSURANCE PROGRAM COMPLETED FOR BEARING SOILS, BACK FILL AND DEWATERING (CHIMNEY DRAIN).
 - CHANGES APPROVED BY THE GEOTECHNICAL ENGINEER

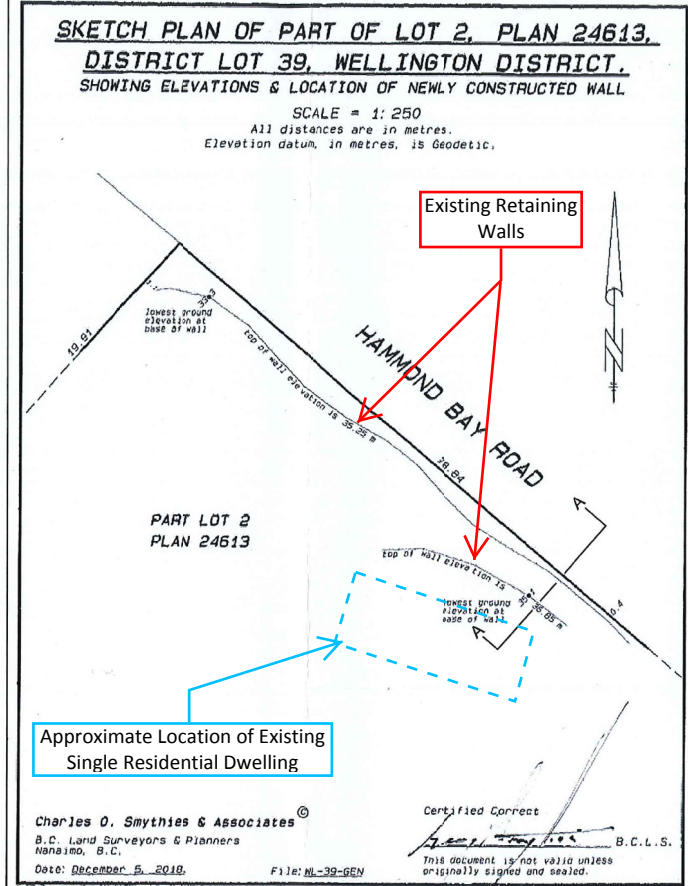

RECEIVED
DVP377
2019-JAN-11
Current Planning

REV No.	DATE	BY	P.Eng.	REVISION DESCRIPTION	LEGEND	DRAWING TITLE	ENGINEER'S SEAL	PLOT DATE	DRAWN BY	LEA Lewkowich Engineering Associates Ltd.
01	June 16-17	JH	CH	ADD OVERALL HEIGHT DIMENSION		REDI-ROCK RETAINING WALLS		MAY 11-17	JH	
02	NOV. 14-18	JH	CH	AS BUILT		FRONT YARD IMPROVEMENTS 3583 HAMMOND BAY ROAD, NANAIMO, BC		REVIEWED BY	SCALE	
								CH	AS NOTED	DRAWING No.
								F4482	01	