


SCHEDULE D BUILDING ELEVATIONS AND DETAILS

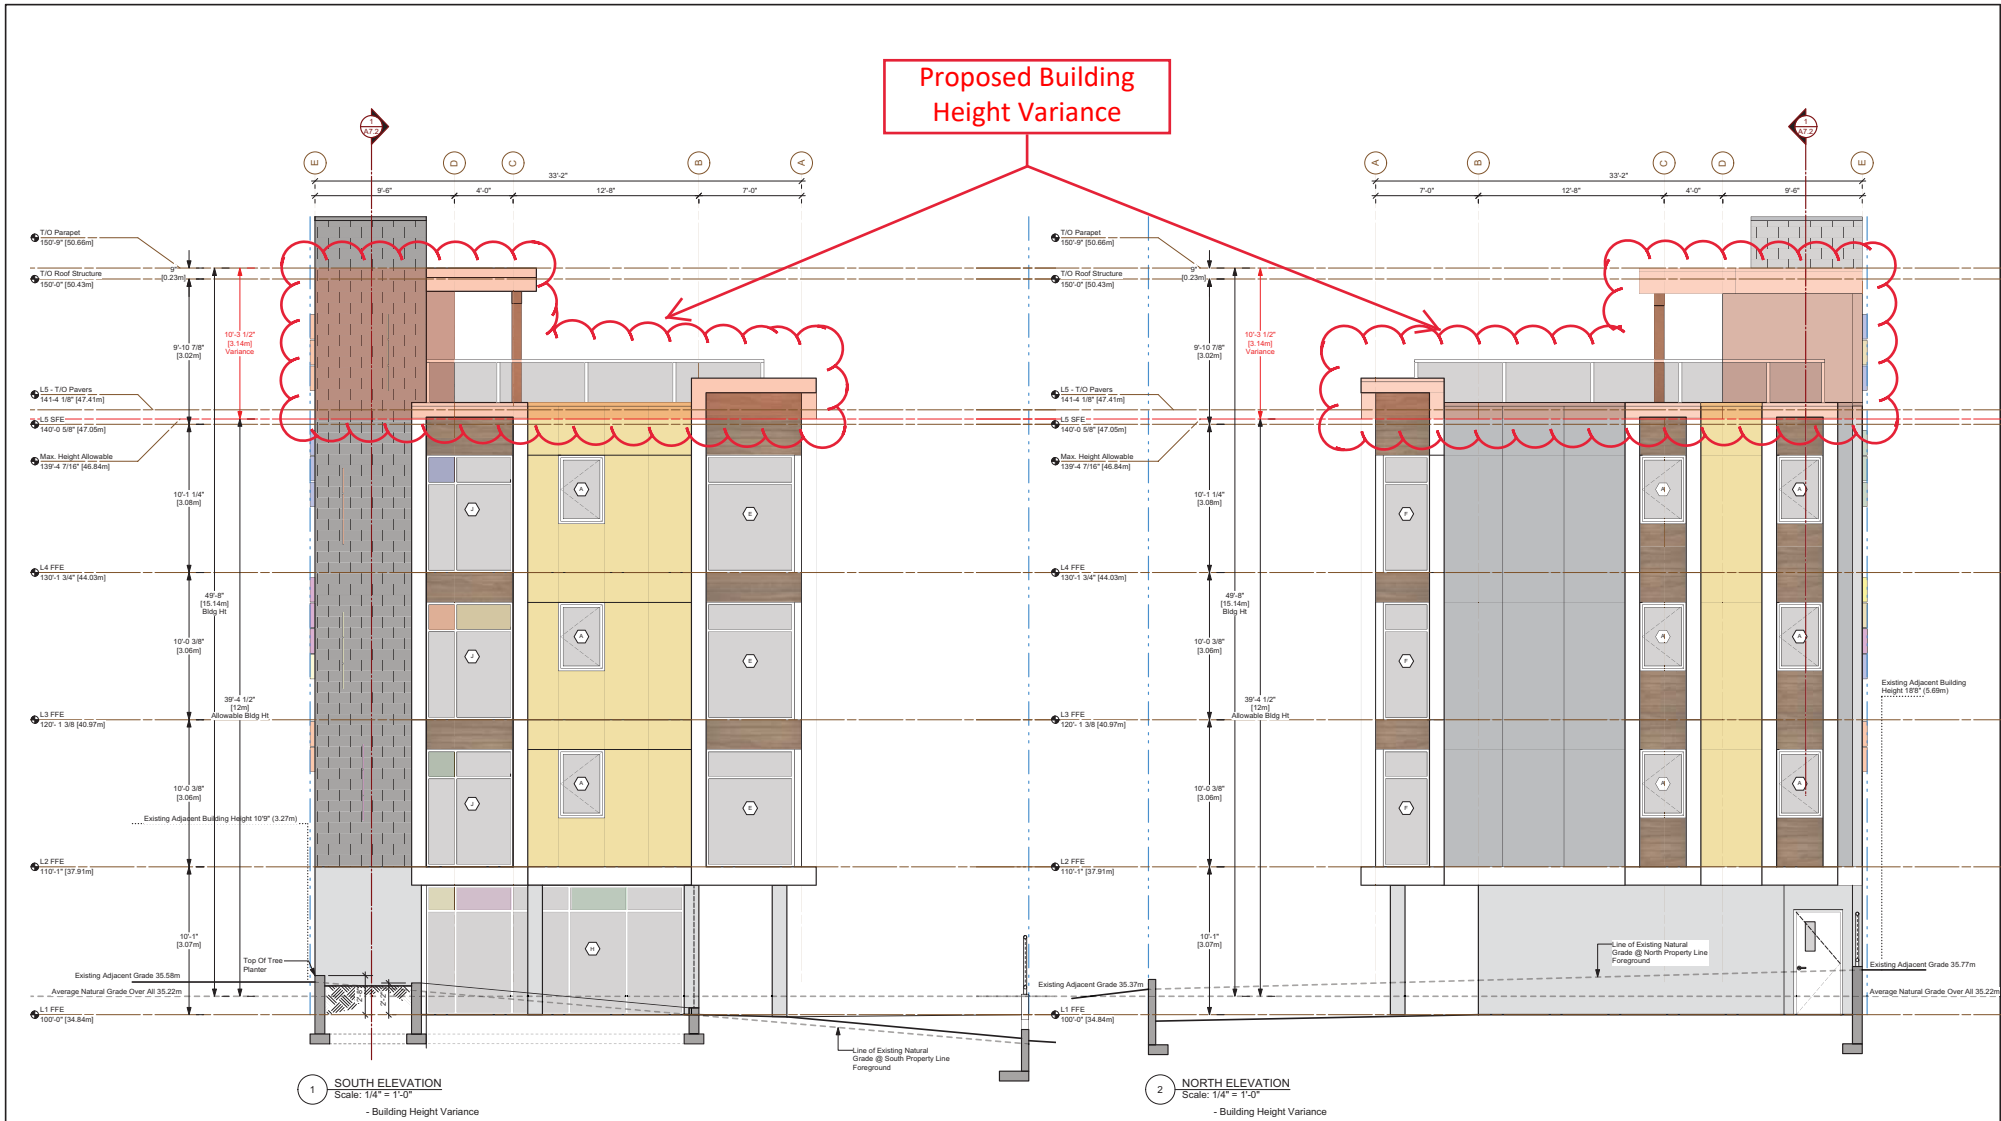

RECEIVED
DP 1136
2019-NOV-29
Current Planning

RAYMOND de BEELD ARCHITECT INC.
755 Terminal Ave. North, Nanaimo, B.C. V9S 4K1
Tel: (250) 754-2108
Email: info@rdbarchitect.ca
www.rdbarchitect.ca

PROJECT CLIENT: Corris
470 Franklyn Street, Nanaimo, BC
The Southerly 92 Feet Of Lot 3, Block 27, Section 1, Nanaimo District,
Plan 584 Except That Part In Plan 221r


SHEET TITLE: ELEVATIONS 1

No.	Date	Issue Notes	No.	Date	Revision Notes
1	2019 10 28	Issued For DP Revision 01 To City of Nanaimo	1	2019 10 27	DP Revision 01
2	2019 11 29	Issued For DP Revision 02 To City of Nanaimo			

Do not scale drawings. Contractor shall verify all dimensions of the work and report any discrepancies to the architect before proceeding. This drawing is not to be used for construction until stamped and signed by the architect.
As an instrument of service, this drawing is the property of the architect and may not be reproduced without permission. This drawing is for the use of the specified project only and shall not be used otherwise without written permission of the architect.

DRWN: RB, RH, KM, KK	CHECKED: RdB
JOB NO: 1903	SHEET NO: A6.1
SCALE: As Noted	DATE: Nov. 29, 2019
CAD FILE: 1803 470 Franklyn 14 - Elev & Sect.vrx	

Proposed Building Height Variance

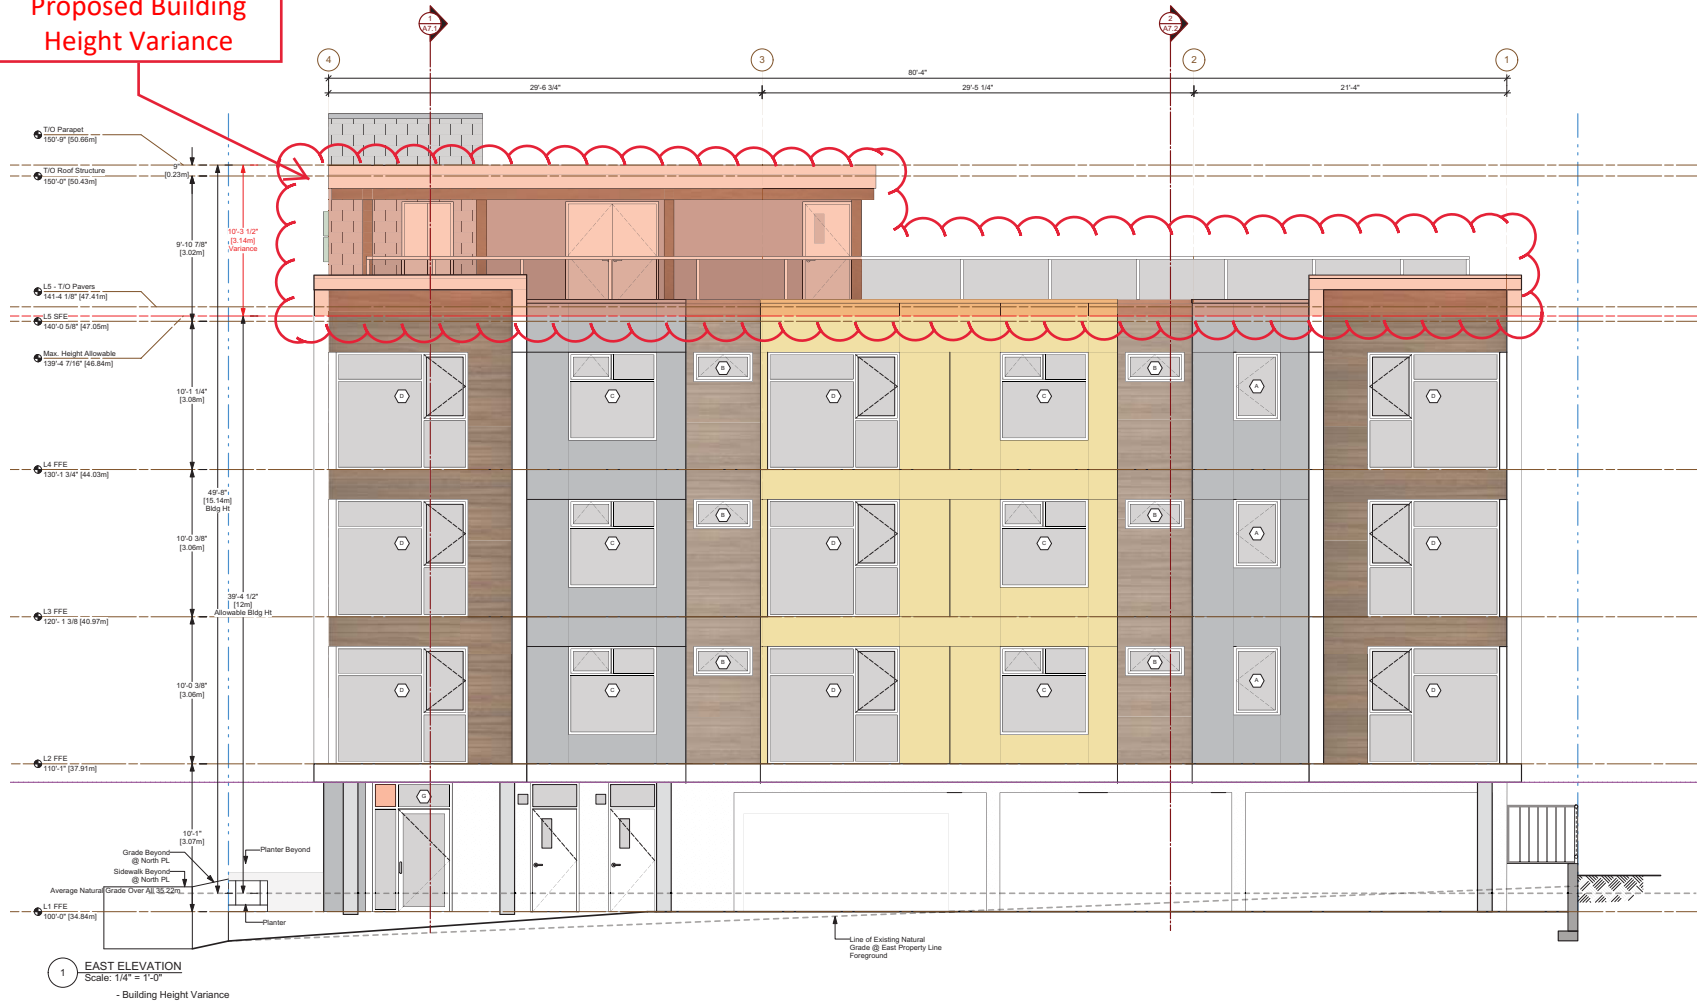

1 EAST ELEVATION
Scale: 1/4" = 1'-0"
- Building Height Variance

RECEIVED
DP 1136
2019-NOV-29
Current Planning

RAYMOND de BEELD ARCHITECT INC.
755 Terminal Ave. North, Nanaimo, B.C. V9S 4K1
Tel: (250) 754-2108
Email: info@rdbarchitect.ca
www.rdbarchitect.ca

PROJECT CLIENT: Corris
470 Franklyn Street, Nanaimo, BC
The Southerly 92 Feet Of Lot 3, Block 27, Section 1, Nanaimo District,
Plan 584 Except That Part In Plan 221r

SHEET TITLE: ELEVATIONS 2

No.	Date	Issue Notes
1	2019 10 28	Issued For DP Revision 01 To City of Nanaimo
2	2019 11 29	Issued For DP Revision 02 To City of Nanaimo


No.	Date	Revision Notes
1	2019 10 27	DP Revision 01

Do not scale drawings. Contractor shall verify all dimensions of the work and report any discrepancies to the architect before proceeding. This drawing is not to be used for construction until stamped and signed by the architect.
As an instrument of service, this drawing is the property of the architect and may not be reproduced without permission. This drawing is for the use of the specified project only and shall not be used otherwise without written permission of the architect.

SEAL (P.E.C. NO.)
DRAWN: RB, RH, KM, KK
JOB NO: 1903
SCALE: As Noted
DATE: Nov. 29, 2019
CAD FILE: 1803 470 Franklyn 14 - Elev & Sect.vrx

CHECKED: RdB
SHEET NO: A6.2

Proposed Building Height Variance

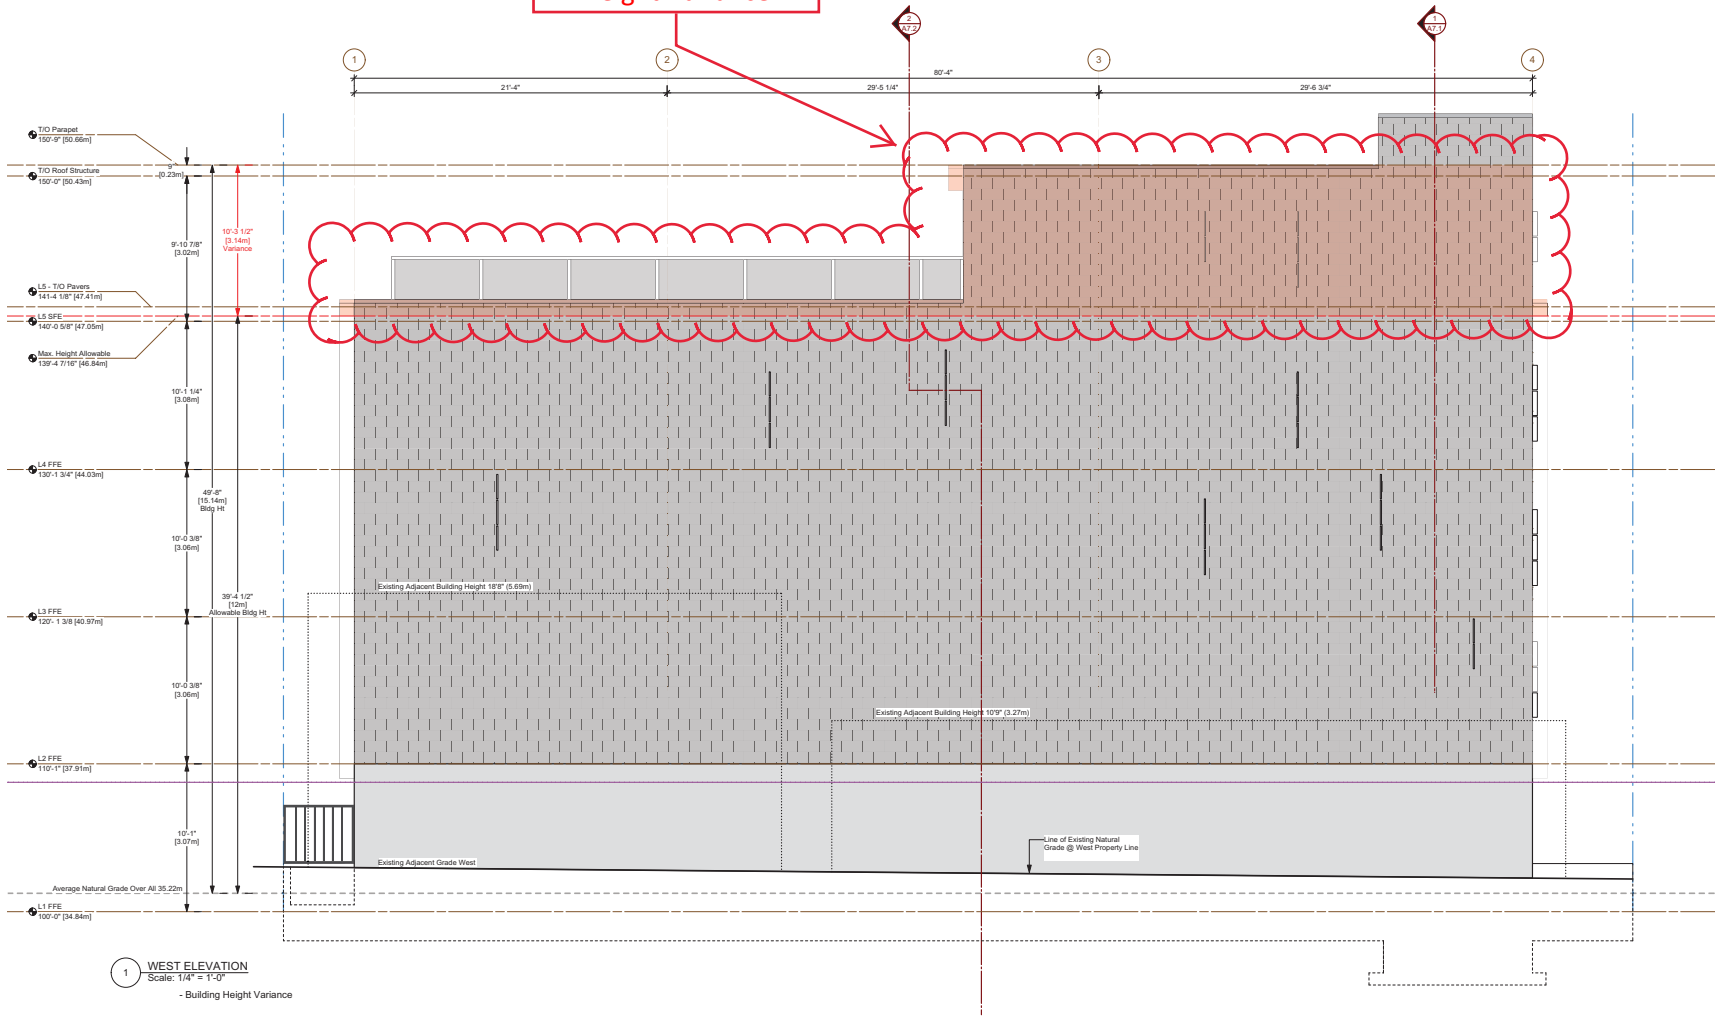

RECEIVED
DP 1136
 2019-NOV-29
 Current Planning

RAYMOND de BEELD ARCHITECT INC.
 755 Terminal Ave. North, Nanaimo, B.C. V9S 4K1
 Tel: (250) 754-2108
 Email: info@rdbarchitect.ca
 www.rdbarchitect.ca

PROJECT CLIENT: Corris
 470 Franklyn Street, Nanaimo, BC
 The Southerly 92 Feet Of Lot 3, Block 27, Section 1, Nanaimo District,
 Plan 584 Except That Part In Plan 221r


SHEET TITLE: ELEVATIONS 3

No.	Date	Issue Notes
1	2019 10 28	Issued For DP Revision 01 To City of Nanaimo
2	2019 11 29	Issued For DP Revision 02 To City of Nanaimo


No.	Date	Revision Notes
1	2019 10 27	DP Revision 01

Do not scale drawings. Contractor shall verify all dimensions of the work and report any discrepancies to the architect before proceeding. This drawing is not to be used for construction until stamped and signed by the architect.
 As an instrument of service, this drawing is the property of the architect and may not be reproduced without permission. This drawing is for the use of the specified project only and shall not be used otherwise without written permission of the architect.


SEAL (RED INK)	DRAWN: RB, RH, KM, KK	CHECKED: RdB
	JOB NO: 1903	SHEET NO:
	SCALE: As Noted	A6.3
	DATE: Nov. 29, 2019	
	CAD FILE: 1803 470 Franklyn 14 - Elev & Sect.wxv	

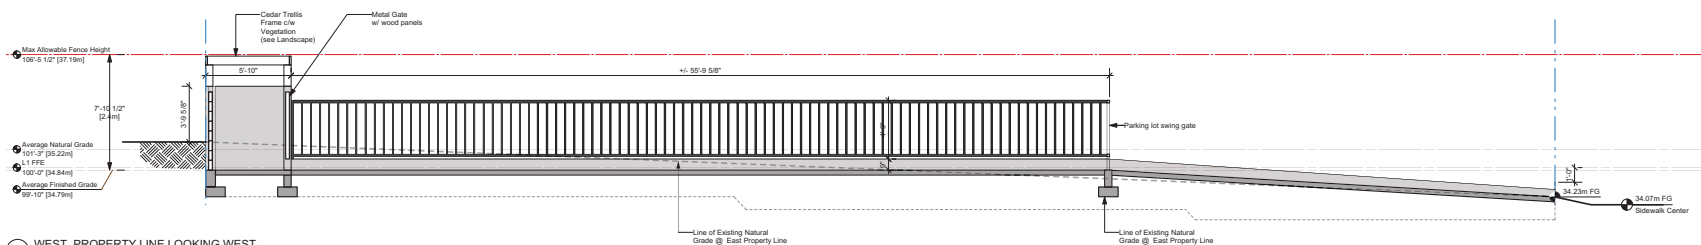


1 WEST PROPERTY LINE LOOKING WEST
Scale: 1/4" = 1'-0"

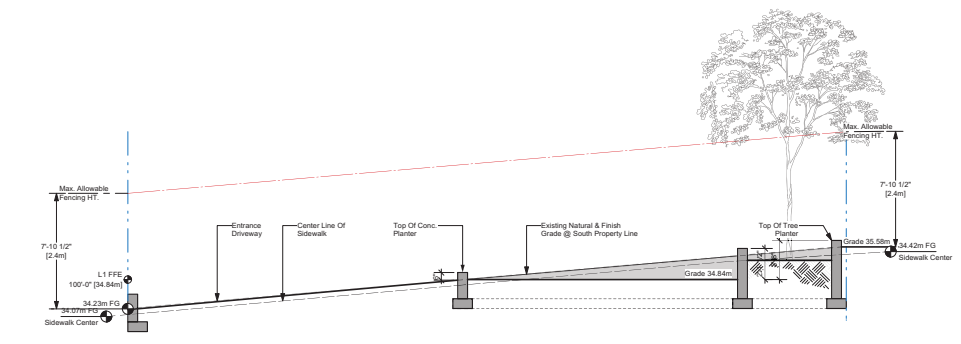

2 SOUTH PROPERTY LINE LOOKING SOUTH
Scale: 1/4" = 1'-0"

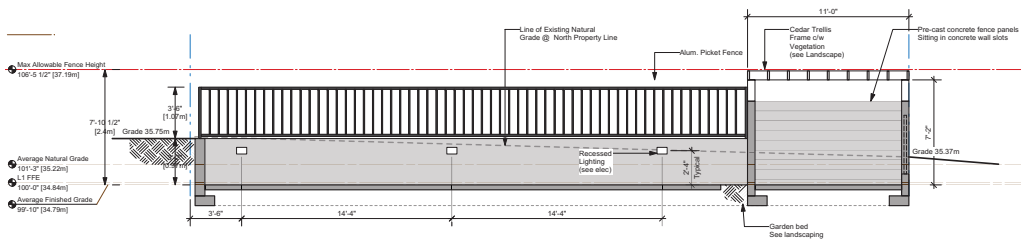

3 NORTH PROPERTY LINE LOOKING NORTH
Scale: 1/4" = 1'-0"

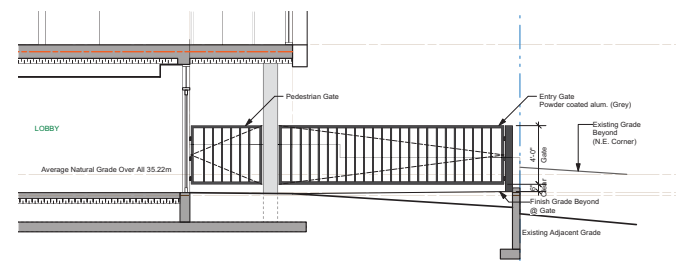

4 DRIVEWAY ENTRANCE GATE ELEVATION
Scale: 1/4" = 1'-0"