

ATTACHMENT C SITE SECTIONS

Fillinger Crescent


Front Property Line

Client

Scott Piccott

Date Revision/Issue

2023 12 14	As Built
2024 02 02	Building Permit
2024 03 08	Building Permit R1
	A-5 Reduced size of W2
	A3.1 Added toilet and sink

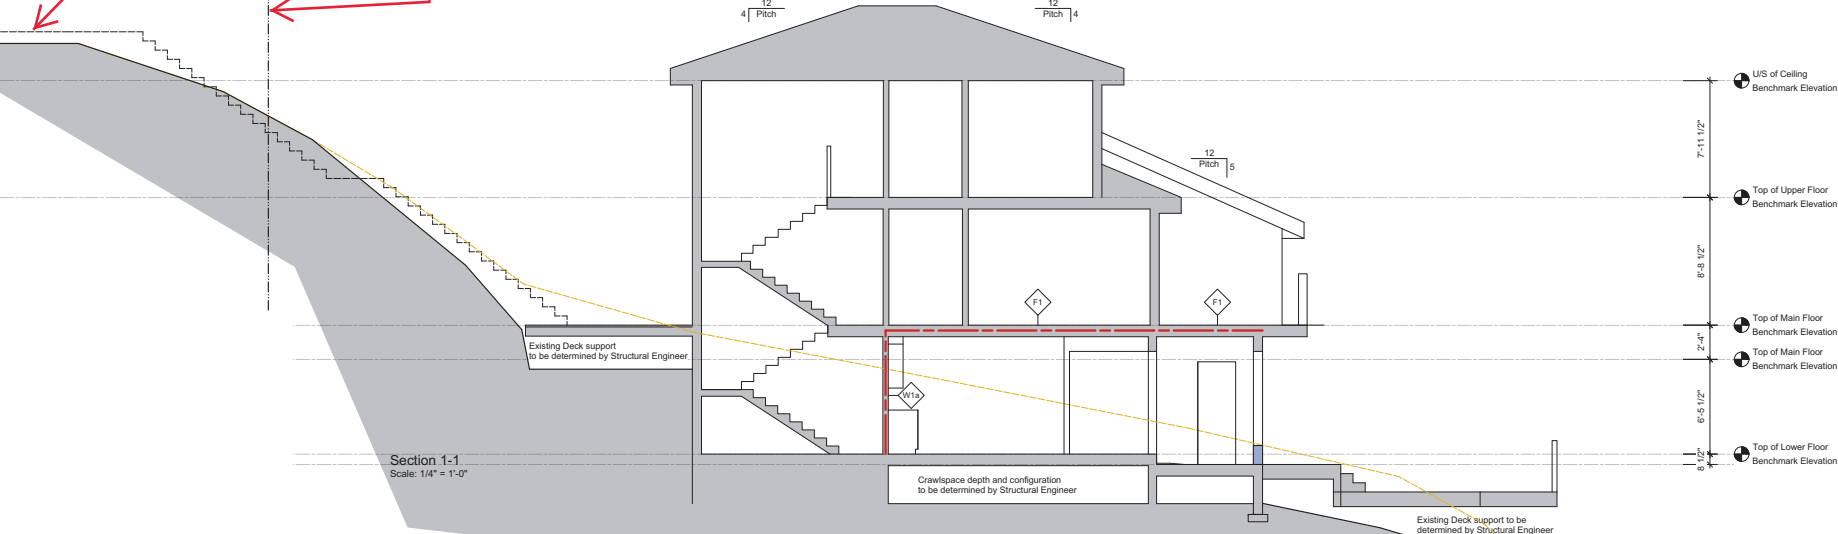

M.A.
MIDDLETON ARCHITECT
553 Larch Street, Nanaimo B.C.
miltonarchitect.com
ram@mla.net
250 713 7697

Seal




Project
Existing As Built
& Proposed Renovation
at
4978 Fillinger Crescent
Nanaimo BC

Sheet Title

Sections

Sheet Number

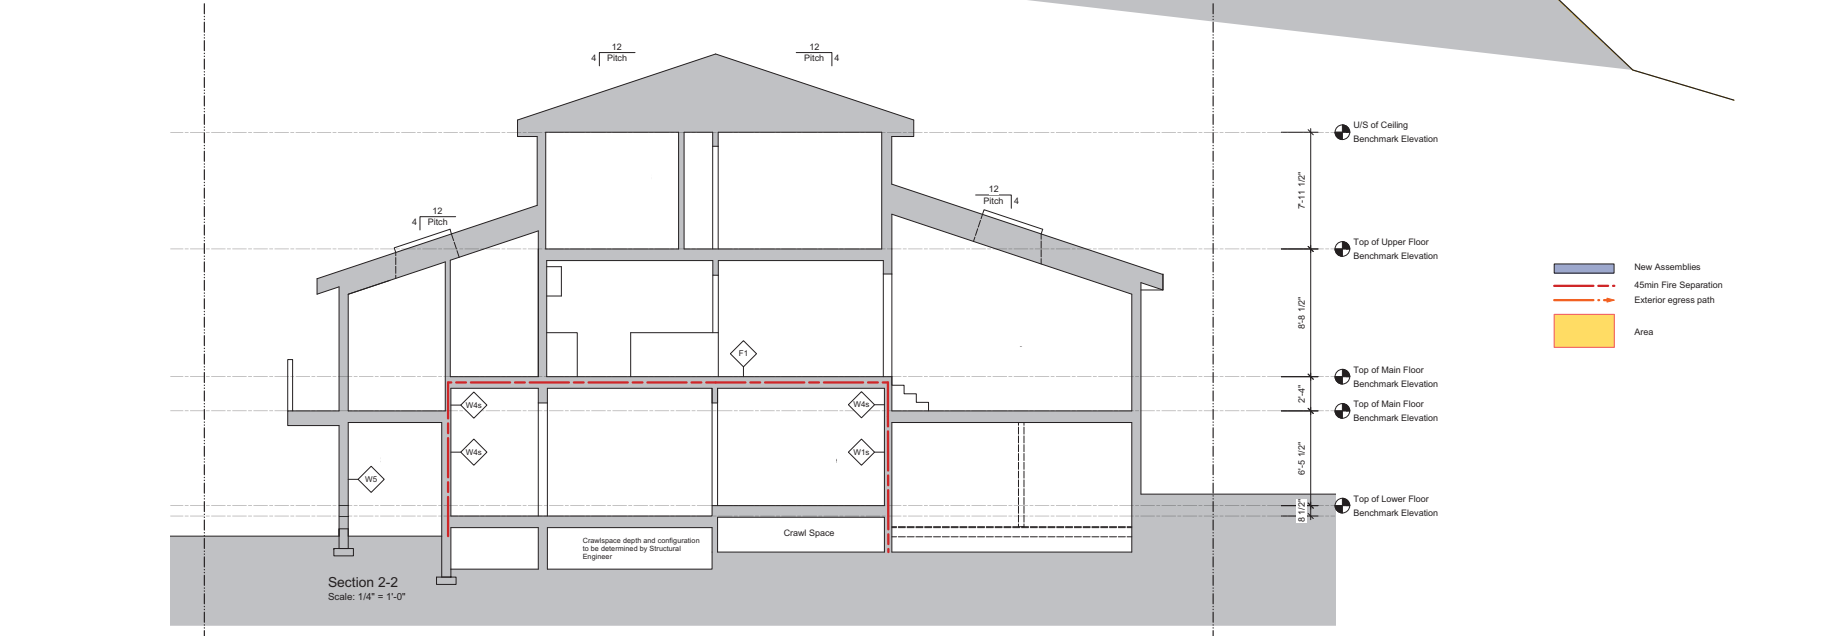

- New Assemblies
- 45min Fire Separation
- Exterior egress path
- Area

A7

RECEIVED
DVP463
2024-JAN-31
CURRENT PLANNING