



# ATTACHMENT B FLOOR PLAN

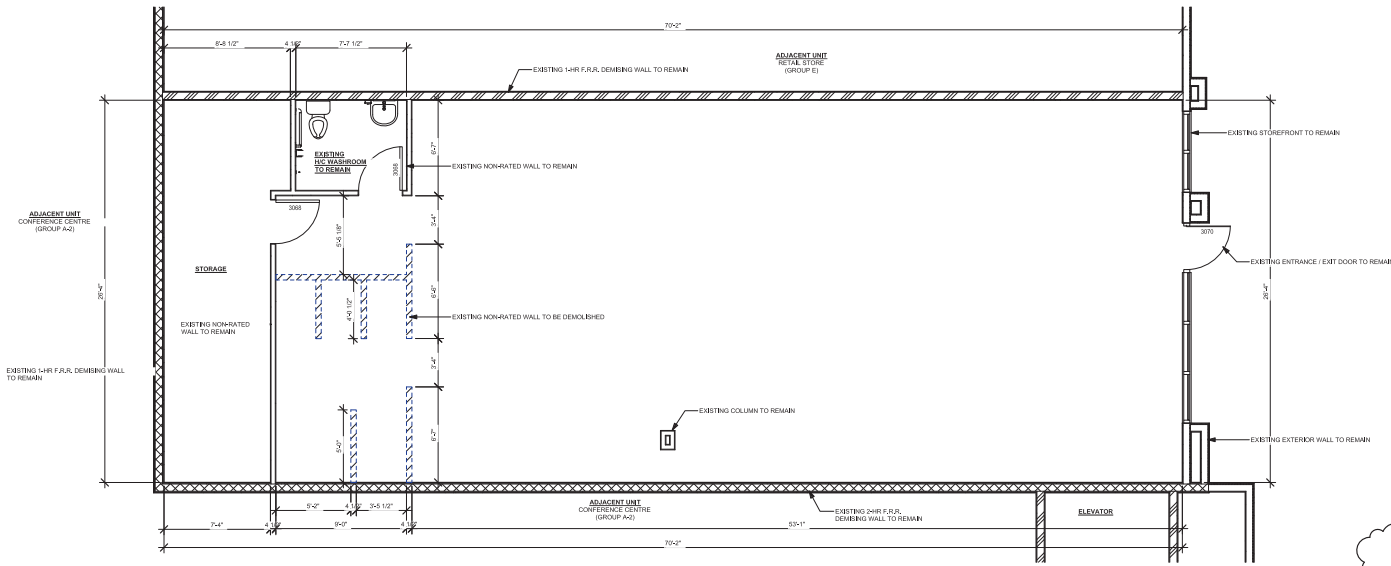


1 EXISTING & DEMOLITION PLAN  
1/4" = 1'-0"

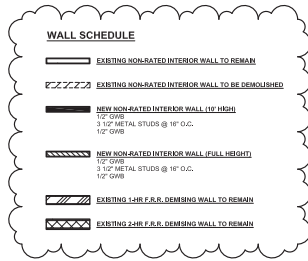

**FIRE SEPARATIONS/FIRE RESISTANCE RATING**

- 0 HOUR: [Blue line]
- 45 MINUTE: [Purple line]
- 1 HOUR: [Yellow line]
- 1.5 HOUR: [Green line]
- 2 HOUR: [Red line]

\*\* EXISTING FIRE SEPARATIONS TO REMAIN AND BE MAINTAINED.

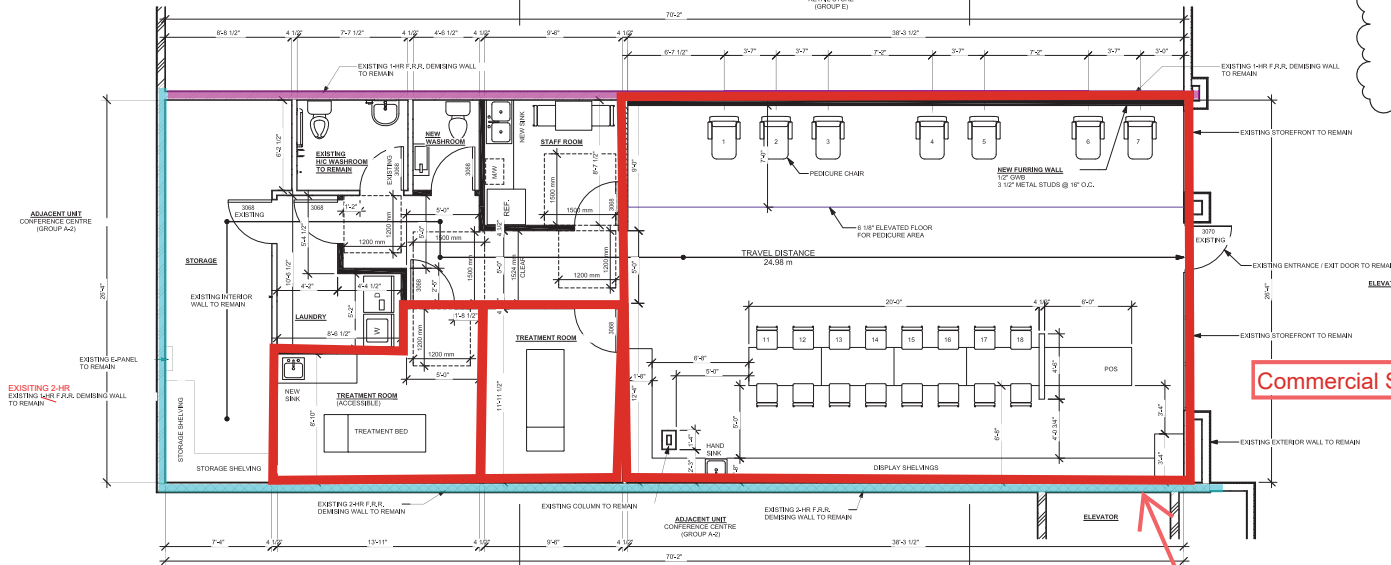

2 PROPOSED PLAN  
1/4" = 1'-0"

Proposed Liquor Service Area

Commercial Street

REVISION FOR WALL SCHEDULE 2023-08-05  
 3 ISSUED FOR RP SUBMITTAL 2023-02-16  
 2 ISSUED FOR COORDINATION 2022-02-03  
 1 ISSUED FOR COORDINATION 2022-01-16

**must'art**  
Interior & Construction

Must'art Interiors & Construction  
 450-1050 Steeles Drive  
 Coquitlam, BC V3R 2Y9  
 PH: 604.270.8800

These drawings are copyrighted and all rights are reserved.  
 No part of these drawings may be reproduced, stored in a retrieval system, or transmitted in any form or by any means, electronic, mechanical, photocopying, recording, or by any information storage and retrieval system, without the prior written permission of Must'art Interiors & Construction. Any use of these drawings without the prior written permission of Must'art Interiors & Construction is strictly prohibited.

File the record of the Owner and General Contractor to verify all alterations and modifications to the construction documents, including the location of any areas, conditions or dimensions.

PROJECT: PARIS HALLS TENANT IMPROVEMENT  
 UNIT 201  
 70 COMMERCIAL STREET  
 NANAIMO, BC  
 DRAWN BY: FLOOR PLANS

Project no. JAN 2022 Scale 1/4" = 1'-0"  
 Project No. 220101 Sheet No. A101

RECEIVED  
**LA158**  
 2025-JAN-06  
 Current Planning

CITY OF NANAIMO  
 BUILDING INSPECTION SECTION  
 PLANS REVIEWED BY:  
 Iboekentinger  
 BPI128316

REVISED:  
 tzuit 09/13/2024  
 Deletion of 3 pedicure chairs